X-330 1023-E

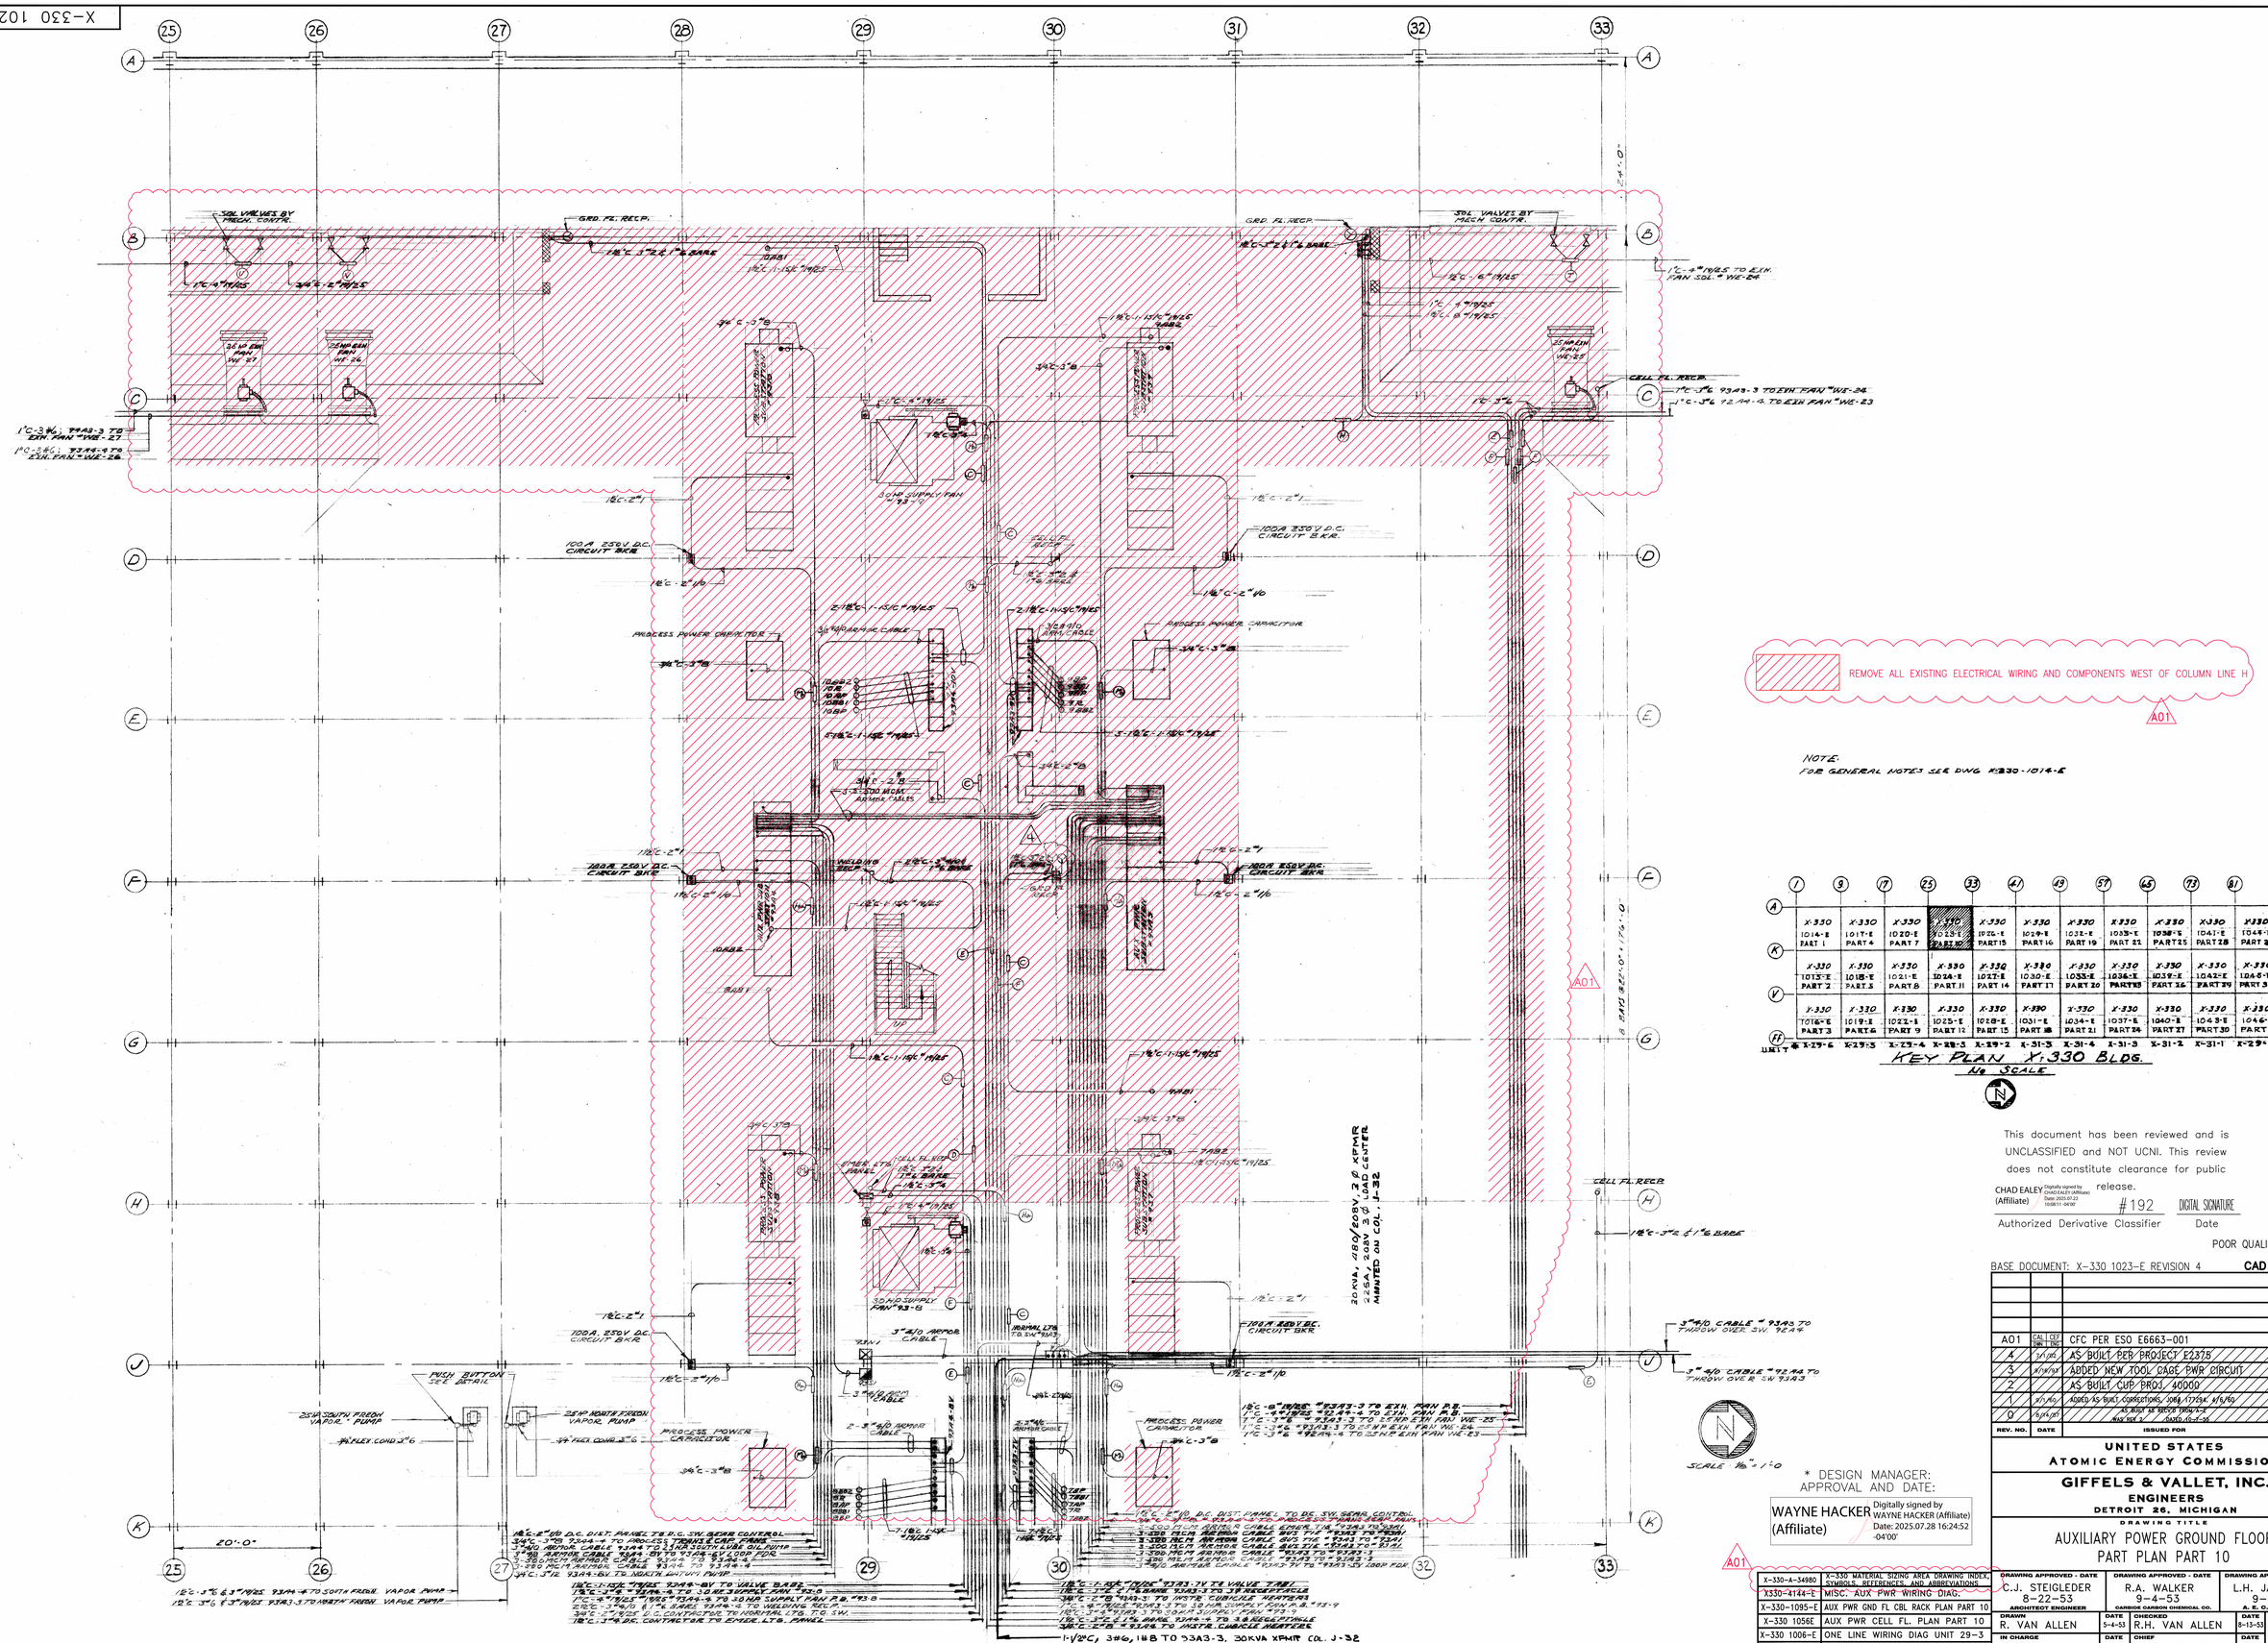

This document has been reviewed and is UNCLASSIFIED and NOT UCNI. This review does not constitute clearance for public release.

CHAD EALEY (Affiliate) Digitally signed by CHAD EALEY (Affiliate) Date: 2025.07.22 10:08:11 -04'00'

#192 — Authorized Derivative Classifier

DIGITAL SIGNATURE — Date

POOR QUALITY ORIGINAL

BASE DOCUMENT: X-330 1023-E REVISION 4 — CAD OVERLAY

REV. NO.	DATE	ISSUED FOR	BY	APP. DATE
A01	CAL SW / CEC ENG	CFC PER ESO E6663-001		*DIG SIG
4	7/1/05	AS BUILT PER PROJECT E2378	SM	TW 8-25-05
3	8/19/03	ADDED NEW TOOL CAGE PWR CIRCUIT	RLH	KJW 9-25-03
2		AS BUILT CUP PROJ. 40000		MKW 1-31-00
1	8/1/60	ADDED AS BUILT CORRECTIONS, JOBS 47754 & 48160	TGB	KJW 1-31-96
0	5/24/55	AS BUILT PER SKETCH 1804-A-2 AND SK # 2 DATED 10-1-56	GK	KJW 1-31-96 KFP

UNITED STATES ATOMIC ENERGY COMMISSION

GIFFELS & VALLET, INC. ENGINEERS DETROIT 26, MICHIGAN

DRAWING TITLE

AUXILIARY POWER GROUND FLOOR PART PLAN PART 10

* DESIGN MANAGER: APPROVAL AND DATE:

WAYNE HACKER (Affiliate) Digitally signed by WAYNE HACKER (Affiliate) Date: 2025.07.28 16:24:52 -04'00'

A01

SHEET NO.	TITLE
X-330-A-34980	X-330 MATERIAL SIZING AREA DRAWING INDEX, SYMBOLS, REFERENCES, AND ABBREVIATIONS
X330-4144-E	MISC. AUX PWR WIRING DIAG.
X-330-1095-E	AUX PWR GND FL CBL RACK PLAN PART 10
X-330 1056E	AUX PWR CELL FL. PLAN PART 10
X-330 1006-E	ONE LINE WIRING DIAG UNIT 29-3
X-330-1001-E	AUX. PWR KEY PLAN

REFERENCE DRAWINGS

DRAWING APPROVED - DATE	DRAWING APPROVED - DATE	DRAWING APPROVED - DATE
C.J. STEIGLEDER 8-22-53 ARCHITECT ENGINEER	R.A. WALKER 9-4-53 CARBIDE CARBON CHEMICAL CO.	L.H. JACKSON 9-8-53 A. E. C. ENGINEER

DRAWN	DATE	CHECKED	DATE	JOB
R. VAN ALLEN	5-4-53	R.H. VAN ALLEN	8-13-53	51-163-X
IN CHARGE	DATE	CHIEF	DATE	
C.J. HAAG	8-19-53	N.R. BJORNSON	8-20-53	

PROJECT	BUILDING	SHEET	REV.
"X" PORTSMOUTH AREA	X-330 1023-E		A01